

**Work Order ID 134360**

Wednesday, July 08, 2015 3:11:11 PM

**\*134360\***

Page 1

Item ID: D3183-9 Accept **\*N900040100\*** Setup Start **\*NS1\***  
 Revision ID: Stop **\*NS2\***  
 Item Name: Cap  
 Start Date: 7/07/15 Start Qty: 25.00 **\*25\*** Cust Item ID:  
 Required Date: 7/07/15 Req'd Qty: 25.00 **\*25\*** Customer:  
 Reference:

Approvals: Process Plan: MLJ Date: JUL 09 2015 Tooling: \_\_\_\_\_ Date: \_\_\_\_\_  
 QC: \_\_\_\_\_ Date: \_\_\_\_\_ SPC (Y/N): \_\_\_\_\_ Date: \_\_\_\_\_  
 Run Start **\*NR1\***  
 Stop **\*NR2\***

| Sequence ID/<br>Work Center ID | Operation<br>Description                 | Set Up/<br>Run Hours | Tool ID | Tool # | Plan<br>Code | Accept<br>Qty | Reject<br>Qty | Reject<br>Number | Insp.<br>Stamp                         |
|--------------------------------|------------------------------------------|----------------------|---------|--------|--------------|---------------|---------------|------------------|----------------------------------------|
| <b>Draw Nbr</b>                | <b>Revision Nbr</b>                      |                      |         |        |              |               |               |                  |                                        |
| D3183                          | Rev C1                                   |                      |         |        |              |               |               |                  |                                        |
| 100                            | Hardinge CNC LATHE SMALL                 | 0.00                 |         |        |              |               |               |                  | <b>DAS</b><br><b>25</b><br><b>9-89</b> |
| <b>*100*</b>                   |                                          |                      |         |        |              |               |               |                  |                                        |
| Hardinge                       | Memo                                     | 0.02                 |         |        |              |               |               |                  |                                        |
| Hardinge CNC Lathe Small       | Turn D3183-9 Cap as per Folio FA388Debur |                      |         |        |              |               |               |                  |                                        |
| 110                            | QC2- Inspect parts off machine FAI/FAIB  | 0.00                 |         |        |              |               |               |                  | <b>DAS</b><br><b>25</b><br><b>9-89</b> |
| <b>*110*</b>                   |                                          |                      |         |        |              |               |               |                  |                                        |
| QC                             | Memo                                     | 0.00                 |         |        |              |               |               |                  |                                        |
| Quality Control                |                                          |                      |         |        |              |               |               |                  |                                        |
| 120                            | QC8- Inspect parts - second check        | 0.00                 |         |        |              |               |               |                  |                                        |
| <b>*120*</b>                   |                                          |                      |         |        |              |               |               |                  |                                        |
| QC                             | Memo                                     | 0.01                 |         |        |              |               |               |                  |                                        |
| Quality Control                |                                          |                      |         |        |              |               |               |                  |                                        |

26

26

25

φ

Off 2015-07-21

DQA: \_\_\_\_\_ Date: \_\_\_\_\_



## WORK ORDER NON-CONFORMANCE / UPDATE

QA Closed: \_\_\_\_\_ Date: \_\_\_\_\_

Work Order update only ☐

|                                                              |                          
|--------------------------------------------------------------|--------------------------|---|--------------------------|---|--------------------------|-----------------------------------|----------------------------------------------|-----------------------|--------------------------|----------------------|--------------------------|-----------|-------------|-----------|-----------|-------------------|---------|---------------|-----------|---------------------|-------|-----------|-----------|----------|--|
| Work Order: _____<br><br>Part No. _____<br><br>NCR-No. _____ |                          | <b>DISPOSITION</b><br><br>Rework <input type="checkbox"/><br>Scrap <input type="checkbox"/><br>Use-as-is <input type="checkbox"/><br>Suspected Unapproved <input type="checkbox"/> |                          | <b>AGAINST DEPARTMENT/PROCESS</b><br><br><table style="width:100%; border: none;"> <tr> <td style="width:15%;">Skid-tube</td><td style="width:15%;">Cross tube</td><td style="width:15%;">Water Jet</td><td style="width:15%;">Engineering</td></tr> <tr> <td>Machining</td><td>Small Fab</td><td>Prod. Eng. Coord.</td><td>Quality</td></tr> <tr> <td>Thermoforming</td><td>Finishing</td><td>Rec/Store/Packaging</td><td>Other</td></tr> <tr> <td>Large Fab</td><td>Composite</td><td>Supplier</td><td></td></tr> </table> |                          |                                   |                                              |                       |                          | Skid-tube            | Cross tube               | Water Jet | Engineering | Machining | Small Fab | Prod. Eng. Coord. | Quality | Thermoforming | Finishing | Rec/Store/Packaging | Other | Large Fab | Composite | Supplier |  |
| Skid-tube                                                    | Cross tube               | Water Jet   | Engineering              |   |                          
| Machining                                                    | Small Fab                | Prod. Eng. Coord.   | Quality                  |   |                          
| Thermoforming                                                | Finishing                | Rec/Store/Packaging   | Other                    |   |                          
| Large Fab                                                    | Composite                | Supplier   |                          |   
| Date :                                                       |                          | Step #:   |                          | QTY Effective :   |                          |                                   | MRB (QSI042) Approval                        |                       |                          |                      |                          |           |             |           |           |                   |         |               |           |                     |       |           |           |          |  |
| Description Work Order Deviation                             |                          |   |                          | Disposition   |                          |                                   | Completed By                                 |                       |                          |                      |                          |           |             |           |           |                   |         |               |           |                     |       |           |           |          |  |
|                                                              |                          |   |                          |   |                          |                                   | Lead hand / Supervisor Approval Verification |                       |                          |                      |                          |           |             |           |           |                   |         |               |           |                     |       |           |           |          |  |
|                                                              |                          |   |                          |   |                          |                                   | QC / QA Coordinator Approval                 |                       |                          |                      |                          |           |             |           |           |                   |         |               |           |                     |       |           |           |          |  |
|                                                              |                          
| Root Cause                                                   |                          | FAULT CATEGORY   |                          |   
| Environment                                                  | <input type="checkbox"/> | No Re-verification   | <input type="checkbox"/> | Pressure/Forced   | <input type="checkbox"/> | Temperature/Cure                  | <input type="checkbox"/>                     | Power Loss/Surge      | <input type="checkbox"/> | Positioned Wrong     | <input type="checkbox"/> |           |             |           |           |                   |         |               |           |                     |       |           |           |          |  |
| Design                                                       | <input type="checkbox"/> | Operator   | <input type="checkbox"/> | Bending   | <input type="checkbox"/> | Set-up                            | <input type="checkbox"/>                     | Folio/Program         | <input type="checkbox"/> | Outside Dimensions   | <input type="checkbox"/> |           |             |           |           |                   |         |               |           |                     |       |           |           |          |  |
| Doc/Data                                                     | <input type="checkbox"/> | Offset/Setup   | <input type="checkbox"/> | Centre Not Concentric   | <input type="checkbox"/> | BOM/Route                         | <input type="checkbox"/>                     | Grain                 | <input type="checkbox"/> | Over/Under tolerance | <input type="checkbox"/> |           |             |           |           |                   |         |               |           |                     |       |           |           |          |  |
| Equip/Tooling                                                | <input type="checkbox"/> | Supplier   | <input type="checkbox"/> | Cracks   | <input type="checkbox"/> | Broken/Damage/Defect              | <input type="checkbox"/>                     | Weld                  | <input type="checkbox"/> | Part Incorrect       | <input type="checkbox"/> |           |             |           |           |                   |         |               |           |                     |       |           |           |          |  |
| Handling/Pre                                                 | <input type="checkbox"/> | Training   | <input type="checkbox"/> | Crimp/Kink/Ripple/Wave   | <input type="checkbox"/> | Inspection Incomplete/Unqualified | <input type="checkbox"/>                     | Wrong Stock Pulled    | <input type="checkbox"/> | Part Lost/Missing    | <input type="checkbox"/> |           |             |           |           |                   |         |               |           |                     |       |           |           |          |  |
| Material                                                     | <input type="checkbox"/> | Use for Testing   | <input type="checkbox"/> | Cuffs   | <input type="checkbox"/> | Contamination                     | <input type="checkbox"/>                     | Out of Sequence       | <input type="checkbox"/> | Part Moved           | <input type="checkbox"/> |           |             |           |           |                   |         |               |           |                     |       |           |           |          |  |
| Internal Transport                                           | <input type="checkbox"/> | Poor Information   | <input type="checkbox"/> | Crushing   | <input type="checkbox"/> | Countersink                       | <input type="checkbox"/>                     | Off-set               | <input type="checkbox"/> | Drawing              | <input type="checkbox"/> |           |             |           |           |                   |         |               |           |                     |       |           |           |          |  |
| Tribal Knowledge                                             | <input type="checkbox"/> | Rushing   | <input type="checkbox"/> | Heat Treat   | <input type="checkbox"/> | Cut Too Short                     | <input type="checkbox"/>                     | Mislabeled            | <input type="checkbox"/> | Finish               | <input type="checkbox"/> |           |             |           |           |                   |         |               |           |                     |       |           |           |          |  |
| LOA                                                          | <input type="checkbox"/> | Product Improvement   | <input type="checkbox"/> | Wave/Twist in Tube   | <input type="checkbox"/> | Instructions Incomplete/Unclear   | <input type="checkbox"/>                     | Fit/Function          | <input type="checkbox"/> | Misread              | <input type="checkbox"/> |           |             |           |           |                   |         |               |           |                     |       |           |           |          |  |
| Substation                                                   | <input type="checkbox"/> | Process Improvement   | <input type="checkbox"/> | Marks/Chatter   | <input type="checkbox"/> | Drill Holes                       | <input type="checkbox"/>                     | Misaligned/off center | <input type="checkbox"/> | Turning Sequence     | <input type="checkbox"/> |           |             |           |           |                   |         |               |           |                     |       |           |           |          |  |
| Past Expiry Date                                             | <input type="checkbox"/> | Manufacturing Process   | <input type="checkbox"/> | OTHER :   |                          |                                   
| Misidentified                                                | <input type="checkbox"/> | Past Due   | <input type="checkbox"/> |   |                          

# Work Order ID 134360

Wednesday, July 08, 2015 3:11:11 PM

**\*134360\***

Page 2

Item ID: D3183-9 Accept **\*N900040100\*** Setup Start **\*NS1\***  
Revision ID: Stop **\*NS2\***  
Item Name: Cap  
Start Date: 7/07/15 Start Qty: 25.00 **\*25\*** Cust Item ID:  
Required Date: 7/07/15 Req'd Qty: 25.00 **\*25\*** Customer:  
Reference:

Approvals: Process Plan: \_\_\_\_\_ Date: \_\_\_\_\_ Tooling: \_\_\_\_\_ Date: \_\_\_\_\_ Run Start **\*NR1\***  
QC: \_\_\_\_\_ Date: \_\_\_\_\_ SPC (Y/N): \_\_\_\_\_ Date: \_\_\_\_\_ Stop **\*NR2\***

| Sequence ID/<br>Work Center ID | Operation<br>Description                           | Set Up/<br>Run Hours | Tool ID | Tool # | Plan<br>Code | Accept<br>Qty | Reject<br>Qty | Reject<br>Number | Insp.<br>Stamp |
|--------------------------------|----------------------------------------------------|----------------------|---------|--------|--------------|---------------|---------------|------------------|----------------|
| 130                            | Identify as per dwg & Stock Location: <u>Stoxx</u> | 0.00                 |         |        |              | 25            | 27            |                  |                |
| <b>*130*</b>                   |                                                    |                      |         |        |              |               |               |                  |                |
| Packaging                      | Memo                                               | 0.00                 |         |        |              |               |               |                  |                |
| Packaging                      |                                                    |                      |         |        |              |               |               |                  |                |
|                                |                                                    |                      |         |        |              |               |               |                  |                |
|                                |                                                    |                      |         |        |              |               |               |                  |                |
| 140                            | QC21- Final Inspection - Work Order Release        | 0.00                 |         |        |              |               |               |                  |                |
| <b>*140*</b>                   |                                                    |                      |         |        |              |               |               |                  |                |
| QC                             | Memo                                               | 0.04                 |         |        |              |               |               |                  |                |
| Quality Control                |                                                    |                      |         |        |              |               |               |                  |                |

JUL 21 2015

MCS

JUL 21 2015

*(Handwritten signature)* 7-21

DQA: \_\_\_\_\_ Date: \_\_\_\_\_



## WORK ORDER NON-CONFORMANCE / UPDATE

QA Closed: \_\_\_\_\_ Date: \_\_\_\_\_

Work Order update only ☐

|   |  |   |  |   |  |  |                       |                                              |  |
|---|--|---|--|---|--|--|-----------------------|----------------------------------------------|--|
| Work Order: _____<br><br>Part No. _____<br><br>NCR No. _____   |  | <b>DISPOSITION</b><br><br>Rework <input type="checkbox"/><br>Scrap <input type="checkbox"/><br>Use-as-is <input type="checkbox"/><br>Suspected Unapproved <input type="checkbox"/>   |  | <b>AGAINST DEPARTMENT/PROCESS</b><br><br><div style="display: flex; justify-content: space-between;"> <div>             Skid-tube <input type="checkbox"/><br/>             Machining <input type="checkbox"/><br/>             Thermoforming <input type="checkbox"/><br/>             Large Fab <input type="checkbox"/> </div> <div>             Cross tube <input type="checkbox"/><br/>             Small Fab <input type="checkbox"/><br/>             Finishing <input type="checkbox"/><br/>             Composite <input type="checkbox"/> </div> <div>             Water Jet <input type="checkbox"/><br/>             Prod. Eng. Coord. <input type="checkbox"/><br/>             Rec/Store/Packaging <input type="checkbox"/><br/>             Supplier <input type="checkbox"/> </div> <div>             Engineering <input type="checkbox"/><br/>             Quality <input type="checkbox"/><br/>             Other <input type="checkbox"/> </div> </div>   |  |  |                       |                                              |  |
| Date :   |  | Step #:   |  | QTY Effective :   |  |  | MRB (QSI042) Approval |                                              |  |
| Description Work Order Deviation   |  |   |  | Disposition   |  |  |                       | Completed By                                 |  |
|   |  |   |  |   |  |  |                       | Lead hand / Supervisor Approval Verification |  |
|   |  |   |  |   |  |  |                       | QC / QA Coordinator Approval                 |  |
|   |  |   |  |   |  |  |                       |                                              |  |
| <b>Root Cause</b><br><div style="display: flex; justify-content: space-between;"> <div>             Environment <input type="checkbox"/><br/>             Design <input type="checkbox"/><br/>             Doc/Data <input type="checkbox"/><br/>             Equip/Tooling <input type="checkbox"/><br/>             Handling/Pre <input type="checkbox"/><br/>             Material <input type="checkbox"/><br/>             Internal Transport <input type="checkbox"/><br/>             Tribal Knowledge <input type="checkbox"/><br/>             LOA <input type="checkbox"/><br/>             Substation <input type="checkbox"/><br/>             Past Expiry Date <input type="checkbox"/><br/>             Misidentified <input type="checkbox"/> </div> <div>             No Re-verification <input type="checkbox"/><br/>             Operator <input type="checkbox"/><br/>             Offset/Setup <input type="checkbox"/><br/>             Supplier <input type="checkbox"/><br/>             Training <input type="checkbox"/><br/>             Use for Testing <input type="checkbox"/><br/>             Poor Information <input type="checkbox"/><br/>             Rushing <input type="checkbox"/><br/>             Product Improvement <input type="checkbox"/><br/>             Process Improvement <input type="checkbox"/><br/>             Manufacturing Process <input type="checkbox"/><br/>             Past Due <input type="checkbox"/> </div> </div> |  | <b>FAULT CATEGORY</b><br><div style="display: flex; justify-content: space-between;"> <div>             Pressure/Forced <input type="checkbox"/><br/>             Bending <input type="checkbox"/><br/>             Centre Not Concentric <input type="checkbox"/><br/>             Cracks <input type="checkbox"/><br/>             Crimp/Kink/Ripple/Wave <input type="checkbox"/><br/>             Cuffs <input type="checkbox"/><br/>             Crushing <input type="checkbox"/><br/>             Heat Treat <input type="checkbox"/><br/>             Wave/Twist in Tube <input type="checkbox"/><br/>             Marks/Chatter <input type="checkbox"/> </div> <div>             Temperature/Cure <input type="checkbox"/><br/>             Set-up <input type="checkbox"/><br/>             BOM/Route <input type="checkbox"/><br/>             Broken/Damage/Defect <input type="checkbox"/><br/>             Inspection Incomplete/Unqualified <input type="checkbox"/><br/>             Contamination <input type="checkbox"/><br/>             Countersink <input type="checkbox"/><br/>             Cut Too Short <input type="checkbox"/><br/>             Instructions Incomplete/Unclear <input type="checkbox"/><br/>             Drill Holes <input type="checkbox"/> </div> </div> |  | <div style="display: flex; justify-content: space-between;"> <div>             Power Loss/Surge <input type="checkbox"/><br/>             Folio/Program <input type="checkbox"/><br/>             Grain <input type="checkbox"/><br/>             Weld <input type="checkbox"/><br/>             Wrong Stock Pulled <input type="checkbox"/><br/>             Out of Sequence <input type="checkbox"/><br/>             Off-set <input type="checkbox"/><br/>             Misabeled <input type="checkbox"/><br/>             Fit/Function <input type="checkbox"/><br/>             Misaligned/off center <input type="checkbox"/> </div> <div>             Positioned Wrong <input type="checkbox"/><br/>             Outside Dimensions <input type="checkbox"/><br/>             Over/Under tolerance <input type="checkbox"/><br/>             Part Incorrect <input type="checkbox"/><br/>             Part Lost/Missing <input type="checkbox"/><br/>             Part Moved <input type="checkbox"/><br/>             Drawing <input type="checkbox"/><br/>             Finish <input type="checkbox"/><br/>             Misread <input type="checkbox"/><br/>             Turning Sequence <input type="checkbox"/> </div> </div> |  |  |                       |                                              |  |
| OTHER : _____   |  |   |  |   |  |  |                       |                                              |  |

# Picklist Print

Wednesday, July 08, 2015 3:11:11 PM

Page 1

Work Order ID: 134360

\*134360\*

Parent Item: D3183-9

\*D3183-9\*

Parent Item Name: Cap

Start Date: 7/07/15

Required Date: 7/07/15

Start Qty: 25.00

Required Qty: 25.00

Comments: IPP A 06.05.03 New issue KJ

| Component Item ID/<br>Item Name | Replacement<br>Item ID | Mfg/<br>Purch | Bin<br>Item | Primary<br>Location | Last<br>Location | Route<br>Seq ID | Unit of<br>Measure | Qty on<br>Hand | Qty per Kit | Total<br>Qty | Qty<br>Issued | Date<br>Issued | Status |
|---------------------------------|------------------------|---------------|-------------|---------------------|------------------|-----------------|--------------------|----------------|-------------|--------------|---------------|----------------|--------|
| MDELRINR1.000                   |                        | Purchased     |             | No                  |                  | 100             | f                  | 13.0400        | 0.0333      | 1            |               |                |        |

\*MDELRINR1 000\*

Delrin Round Bar 1" color: black

\*\*

JL 15-7-20

Location

Loc Qty

Loc Code

MAT039

13.04

m130188

13.04

1.06

130065

-43

not in system, no more mat'l after this

DQA: \_\_\_\_\_ Date: \_\_\_\_\_



## WORK ORDER NON-CONFORMANCE / UPDATE

QA Closed: \_\_\_\_\_ Date: \_\_\_\_\_

Work Order update only ☐


|                                                              |                                                |   |                                                            |   |                                               |  |                       |                                                 |  |
|--------------------------------------------------------------|------------------------------------------------|---|------------------------------------------------------------|---|-----------------------------------------------|--|-----------------------|-------------------------------------------------|--|
| Work Order: _____<br><br>Part No. _____<br><br>NCR No. _____ |                                                | <b>DISPOSITION</b><br><br>Rework <input type="checkbox"/><br>Scrap <input type="checkbox"/><br>Use-as-is <input type="checkbox"/><br>Suspected Unapproved <input type="checkbox"/> |                                                            | <b>AGAINST DEPARTMENT/PROCESS</b><br><br><div style="display: flex; justify-content: space-between;"> <div>             Skid-tube <input type="checkbox"/><br/>             Machining <input type="checkbox"/><br/>             Thermoforming <input type="checkbox"/><br/>             Large Fab <input type="checkbox"/> </div> <div>             Cross tube <input type="checkbox"/><br/>             Small Fab <input type="checkbox"/><br/>             Finishing <input type="checkbox"/><br/>             Composite <input type="checkbox"/> </div> <div>             Water Jet <input type="checkbox"/><br/>             Prod. Eng. Coord. <input type="checkbox"/><br/>             Rec/Store/Packaging <input type="checkbox"/><br/>             Supplier <input type="checkbox"/> </div> <div>             Engineering <input type="checkbox"/><br/>             Quality <input type="checkbox"/><br/>             Other <input type="checkbox"/> </div> </div> |                                               |  |                       |                                                 |  |
| Date :                                                       |                                                | Step #:   |                                                            | QTY Effective :   |                                               |  | MRB (QSI042) Approval |                                                 |  |
| Description Work Order Deviation                             |                                                |   |                                                            | Disposition   |                                               |  |                       | Completed By                                    |  |
|                                                              |                                                |   |                                                            |   |                                               |  |                       | Lead hand / Supervisor<br>Approval Verification |  |
|                                                              |                                                |   |                                                            |   |                                               |  |                       | QC / QA Coordinator<br>Approval                 |  |
|                                                              |                                                |   |                                                            |   |                                               |  |                       |                                                 |  |
| Root Cause                                                   |                                                | FAULT CATEGORY   |                                                            |   |                                               |  |                       |                                                 |  |
| Environment <input type="checkbox"/>                         | No Re-verification <input type="checkbox"/>    | Pressure/Forced <input type="checkbox"/>   | Temperature/Cure <input type="checkbox"/>                  | Power Loss/Surge <input type="checkbox"/>   | Positioned Wrong <input type="checkbox"/>     |  |                       |                                                 |  |
| Design <input type="checkbox"/>                              | Operator <input type="checkbox"/>              | Bending <input type="checkbox"/>   | Set-up <input type="checkbox"/>                            | Folio/Program <input type="checkbox"/>   | Outside Dimensions <input type="checkbox"/>   |  |                       |                                                 |  |
| Doc/Data <input type="checkbox"/>                            | Offset/Setup <input type="checkbox"/>          | Centre Not Concentric <input type="checkbox"/>   | BOM/Route <input type="checkbox"/>                         | Grain <input type="checkbox"/>   | Over/Under tolerance <input type="checkbox"/> |  |                       |                                                 |  |
| Equip/Tooling <input type="checkbox"/>                       | Supplier <input type="checkbox"/>              | Cracks <input type="checkbox"/>   | Broken/Damage/Defect <input type="checkbox"/>              | Weld <input type="checkbox"/>   | Part Incorrect <input type="checkbox"/>       |  |                       |                                                 |  |
| Handling/Pre <input type="checkbox"/>                        | Training <input type="checkbox"/>              | Crimp/Kink/Ripple/Wave <input type="checkbox"/>   | Inspection Incomplete/Unqualified <input type="checkbox"/> | Wrong Stock Pulled <input type="checkbox"/>   | Part Lost/Missing <input type="checkbox"/>    |  |                       |                                                 |  |
| Material <input type="checkbox"/>                            | Use for Testing <input type="checkbox"/>       | Cuffs <input type="checkbox"/>   | Contamination <input type="checkbox"/>                     | Out of Sequence <input type="checkbox"/>   | Part Moved <input type="checkbox"/>           |  |                       |                                                 |  |
| Internal Transport <input type="checkbox"/>                  | Poor Information <input type="checkbox"/>      | Crushing <input type="checkbox"/>   | Countersink <input type="checkbox"/>                       | Off-set <input type="checkbox"/>   | Drawing <input type="checkbox"/>              |  |                       |                                                 |  |
| Tribal Knowledge <input type="checkbox"/>                    | Rushing <input type="checkbox"/>               | Heat Treat <input type="checkbox"/>   | Cut Too Short <input type="checkbox"/>                     | Mislabeled <input type="checkbox"/>   | Finish <input type="checkbox"/>               |  |                       |                                                 |  |
| LOA <input type="checkbox"/>                                 | Product Improvement <input type="checkbox"/>   | Wave/Twist in Tube <input type="checkbox"/>   | Instructions Incomplete/Unclear <input type="checkbox"/>   | Fit/Function <input type="checkbox"/>   | Misread <input type="checkbox"/>              |  |                       |                                                 |  |
| Substation <input type="checkbox"/>                          | Process Improvement <input type="checkbox"/>   | Marks/Chatter <input type="checkbox"/>   | Drill Holes <input type="checkbox"/>                       | Misaligned/off center <input type="checkbox"/>   | Turning Sequence <input type="checkbox"/>     |  |                       |                                                 |  |
| Past Expiry Date <input type="checkbox"/>                    | Manufacturing Process <input type="checkbox"/> | OTHER :   |                                                            |   |                                               |  |                       |                                                 |  |
| Misidentified <input type="checkbox"/>                       | Past Due <input type="checkbox"/>              |   |                                                            |   |                                               |  |                       |                                                 |  |






|                         |                     |                                                          |                        |
|-------------------------|---------------------|----------------------------------------------------------|------------------------|
| DESIGN<br>#             | DRAWN BY<br>CP      | <b>DART AEROSPACE LTD</b><br>HAWKESBURY, ONTARIO, CANADA |                        |
| CHECKED<br>#            | APPROVED<br>#       | DRAWING NO.<br><b>D3183</b>                              | REV. C<br>SHEET 1 OF 4 |
| DATE<br><b>04.02.17</b> |                     | TITLE<br><b>BRACKET ASSEMBLY</b>                         | SCALE<br>1:1           |
| A                       | 03.01.24            | NEW ISSUE                                                |                        |
| B                       | 03.06.17            | REMOVE BEARING; 1.012 WS 0.882                           |                        |
| C                       | 04.02.17            | ADD -045/-9; 0.182 WAS 0.431                             |                        |
| CI                      | <del>04.11.09</del> | <del>0.830 WAS 0.850</del>                               |                        |

RELEASED  
04.03.01  
DEO ATTACHED

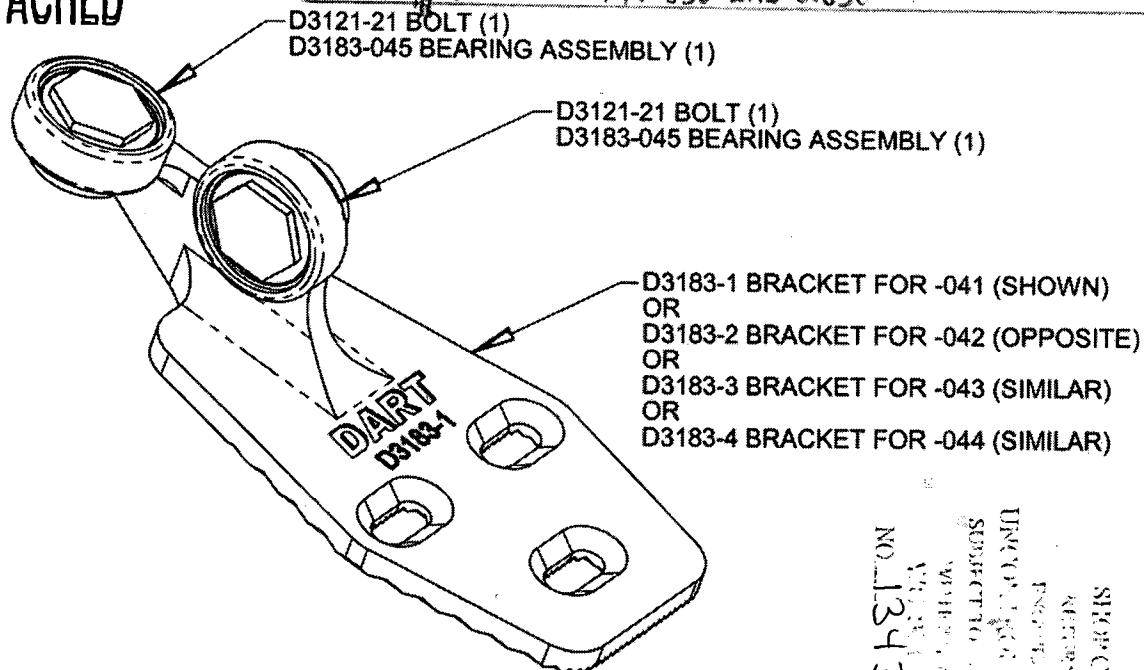


**D3183-041 BRACKET ASSEMBLY (SHOWN)**  
**D3183-042 BRACKET ASSEMBLY (OPPOSITE)**  
**D3183-043 BRACKET ASSEMBLY (SIMILAR)**  
**D3183-044 BRACKET ASSEMBLY (SIMILAR)**

SHOWN COPY  
ATTACHED TO  
PROJECT  
UNCONTROLLED COPY  
SUBJECT TO  
REVISION  
NO. 134360.MJ5  
1503-09

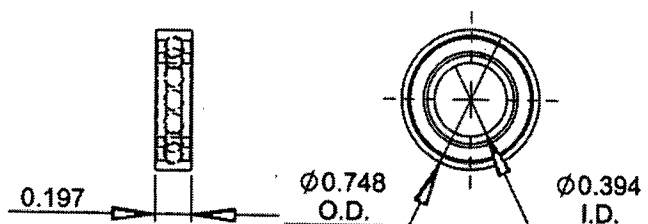

**D3183-5 BEARING:**  
**SPECIFICATION CONTROL DRAWING**

- 1) SINGLE ROW, DEEP GROOVE, CONRAD TYPE, SHIELDED
- 2) POSSIBLE SUPPLIER: NSK P/N 6800ZZ
- 3) ALL DIMENSIONS ARE IN INCHES

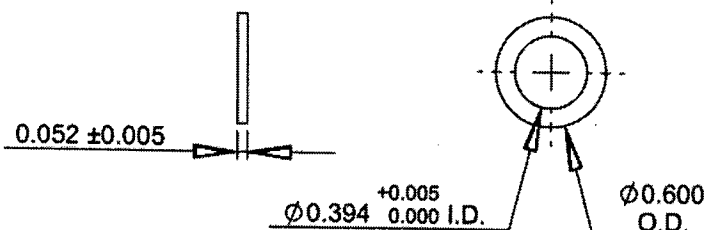

**D3183-7 WASHER**

- 1) MATERIAL: AISI 303 ROUND BAR (M303R) ANNEALED
- 2) BREAK ALL SHARP EDGES 0.005 TO 0.010
- 3) TOLERANCES ARE PER DART QSI 018 UNLESS OTHERWISE NOTED
- 4) ALL DIMENSIONS ARE IN INCHES

**COPYRIGHT © 2003 BY DART AEROSPACE LTD.**

THIS DOCUMENT IS PRIVATE AND CONFIDENTIAL AND IS SUPPLIED ON THE EXPRESS CONDITION THAT IT IS NOT TO BE USED FOR ANY PURPOSE OR COPIED OR COMMUNICATED TO ANY OTHER PERSON WITHOUT WRITTEN PERMISSION FROM DART AEROSPACE LTD.






| DESIGN           | DRAWN BY                  | DART AEROSPACE LTD<br>HAWKESBURY, ONTARIO, CANADA |        |
|------------------|---------------------------|---------------------------------------------------|--------|
| CHECKED          | APPROVED                  | DRAWING NO.<br>D3183                              | REV. C |
| DATE<br>04.02.17 | TITLE<br>BRACKET ASSEMBLY | SHEET 2 OF 4                                      |        |
|                  |                           | SCALE<br>1:2                                      |        |

RELEASED  
04-03-01

DETACHED

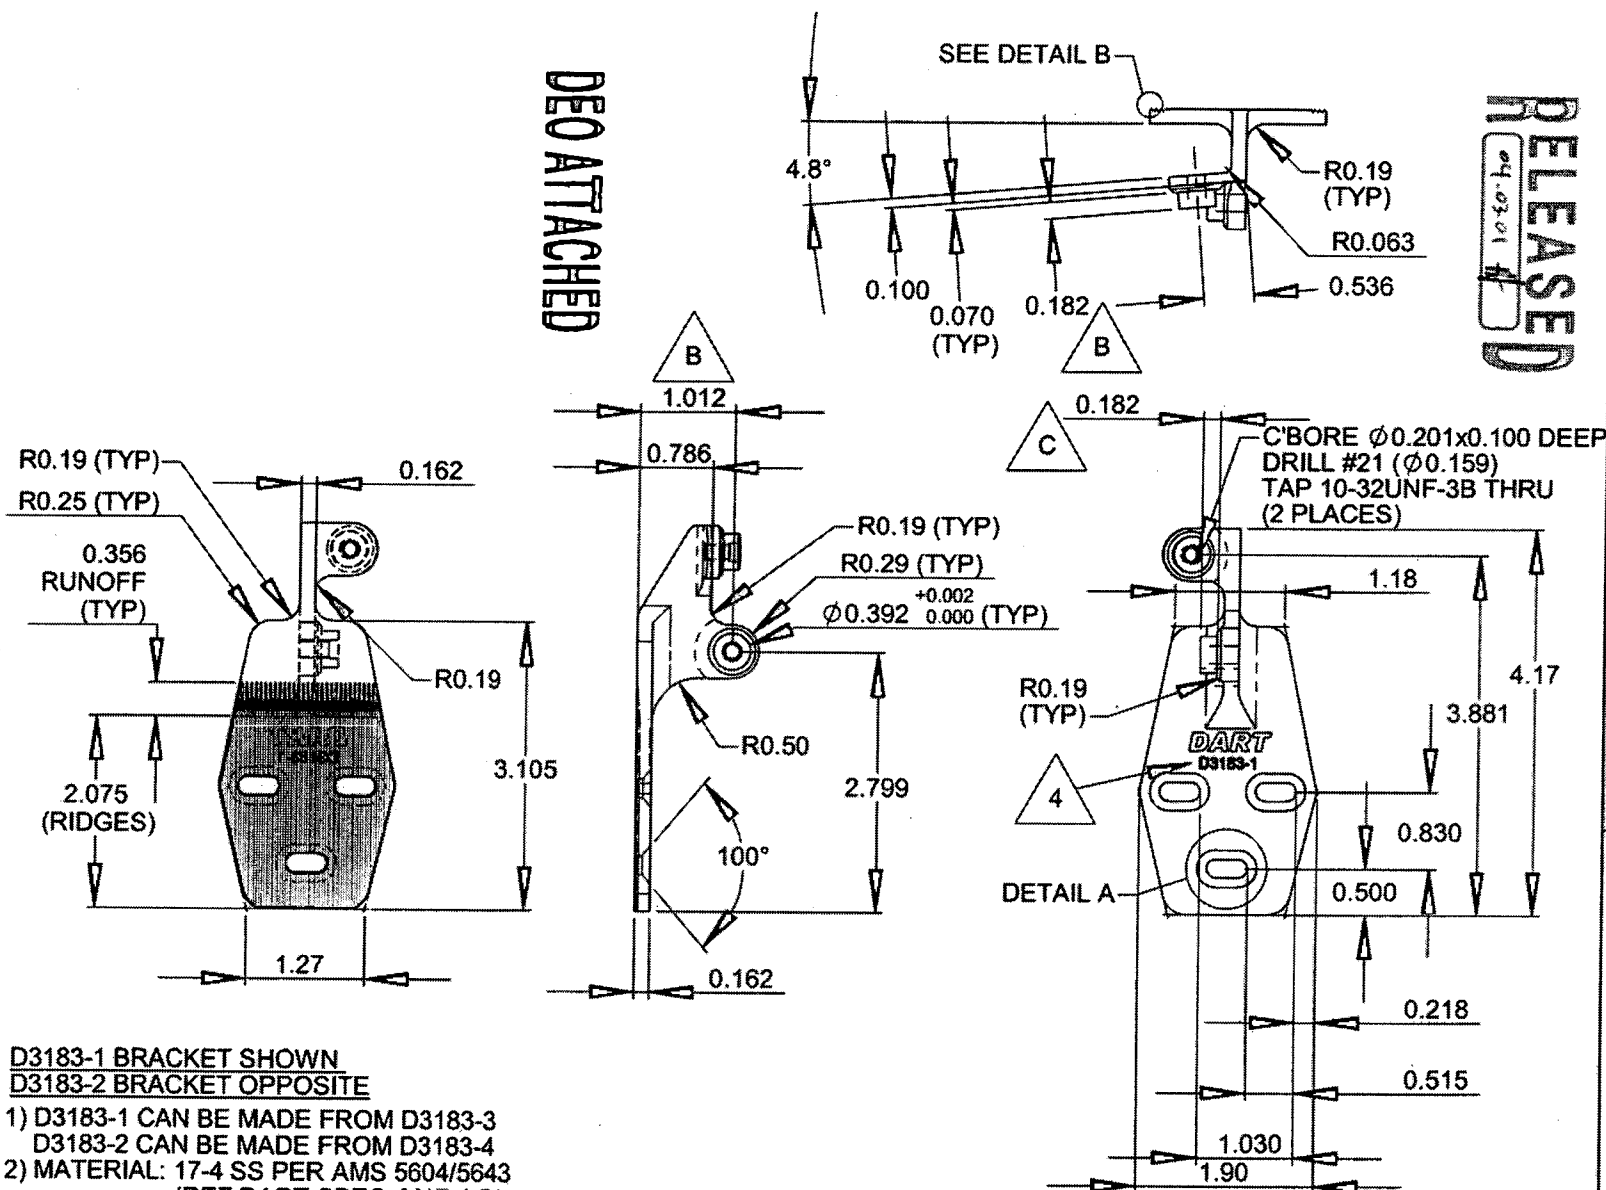

**D3183-1 BRACKET SHOWN  
D3183-2 BRACKET OPPOSITE**



- 1) D3183-1 CAN BE MADE FROM D3183-3  
D3183-2 CAN BE MADE FROM D3183-4
- 2) MATERIAL: 17-4 SS PER AMS 5604/5643  
(REF DART SPEC. M17-4-B)  
MIN ULTIMATE STRENGTH = 150 ksi  
MIN YIELD STRENGTH = 100 ksi
- 3) BREAK ALL SHARP EDGES 0.005 TO 0.015
- 4) ENGRAVE DART P/N & LOGO AS SHOWN
- 5) TOLERANCES ARE PER DART QSI 018 UNLESS OTHERWISE NOTED
- 6) ALL DIMENSIONS ARE IN INCHES

COPYRIGHT © 2003 BY DART AEROSPACE LTD.

THIS DOCUMENT IS PRIVATE AND CONFIDENTIAL AND IS SUPPLIED ON THE EXPRESS CONDITION THAT IT IS NOT TO BE USED FOR ANY PURPOSE OR COPIED OR COMMUNICATED TO ANY OTHER PERSON WITHOUT WRITTEN PERMISSION FROM DART AEROSPACE LTD.



| DESIGN   | DRAWN BY | DART AEROSPACE LTD<br>HAWKESBURY, ONTARIO, CANADA |              |
|----------|----------|---------------------------------------------------|--------------|
| CHECKED  | APPROVED | DRAWING NO.                                       | REV. C       |
| DATE     |          | D3183                                             | SHEET 3 OF 4 |
| 04.02.17 |          | TITLE                                             | SCALE        |
|          |          | BRACKET ASSEMBLY                                  | 1:2          |

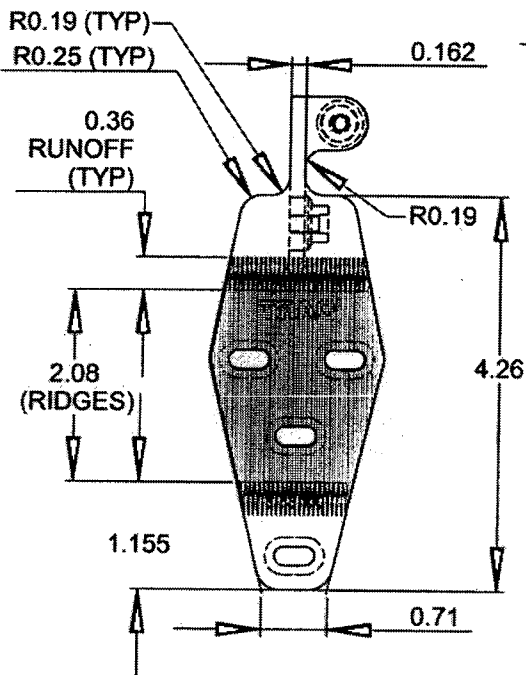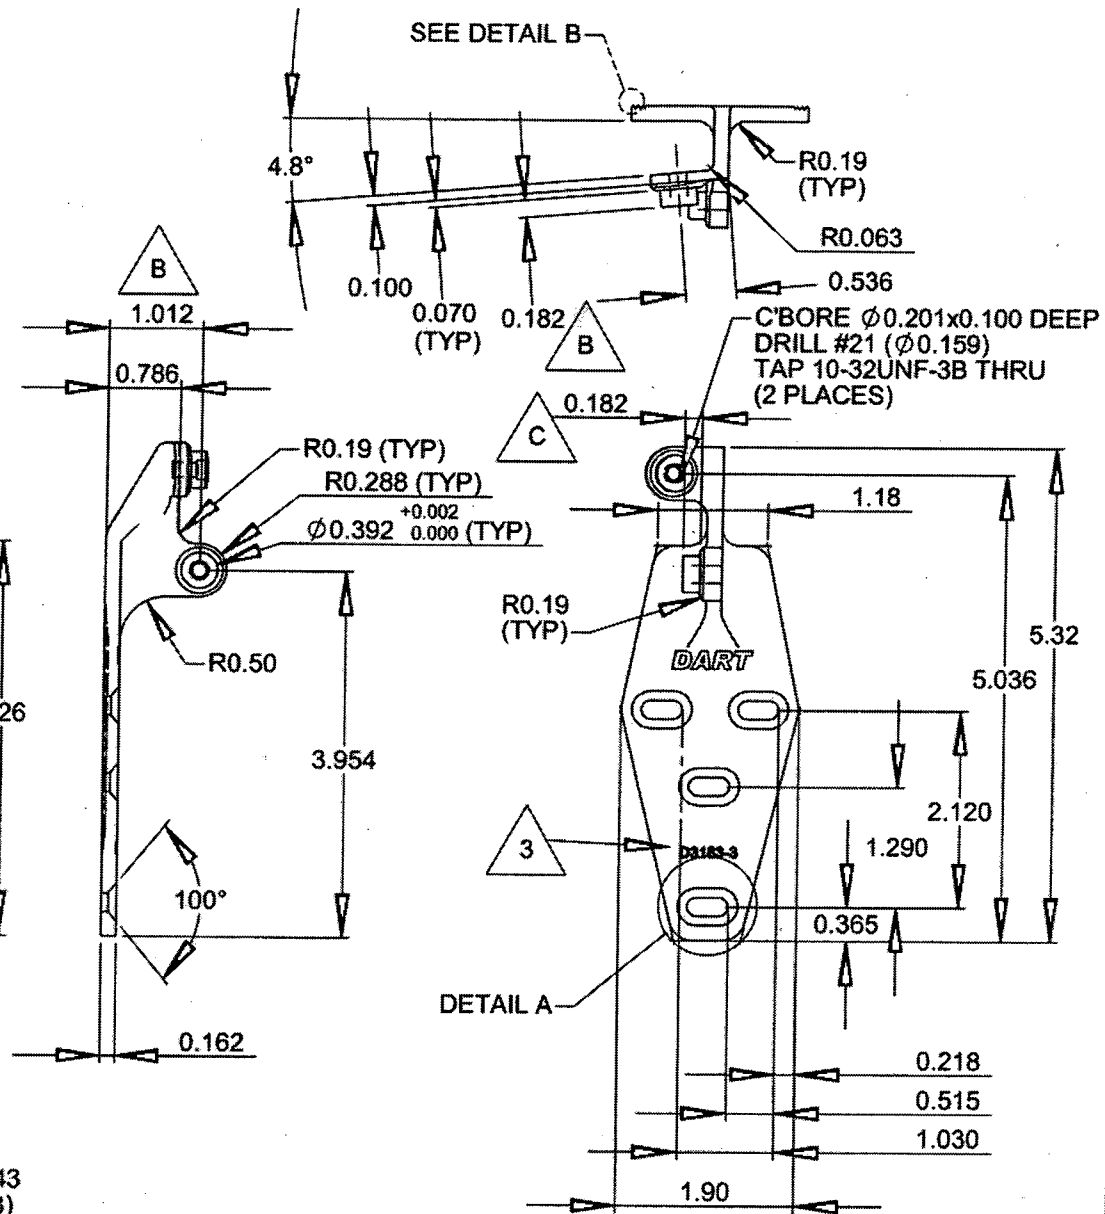

D3183-3 BRACKET SHOWN  
(REPLACES BELL P/N 412-030-304-105)  
D3183-4 BRACKET OPPOSITE  
(REPLACES BELL P/N 412-030-304-106)

- 1) MATERIAL: 17-4 SS PER AMS 5604/5643  
(REF DART SPEC. M17-4-B)  
MIN ULTIMATE STRENGTH = 150 ksi  
MIN YIELD STRENGTH = 100 ksi
- 2) BREAK ALL SHARP EDGES 0.005 TO 0.015
- 3) ENGRAVE DART P/N & LOGO AS SHOWN
- 4) TOLERANCES ARE PER DART QSI 018 UNLESS OTHERWISE NOTED
- 5) ALL DIMENSIONS ARE IN INCHES


DEO ATTACHED  
RELEASED  
04-03-01

COPYRIGHT © 2003 BY DART AEROSPACE LTD.

THIS DOCUMENT IS PRIVATE AND CONFIDENTIAL AND IS SUPPLIED ON THE EXPRESS CONDITION THAT IT IS NOT TO BE USED FOR ANY PURPOSE OR COPIED OR COMMUNICATED TO ANY OTHER PERSON WITHOUT WRITTEN PERMISSION FROM DART AEROSPACE LTD.




|                         |          |                                                          |                        |
|-------------------------|----------|----------------------------------------------------------|------------------------|
| DESIGN                  | DRAWN BY | <b>DART AEROSPACE LTD</b><br>HAWKESBURY, ONTARIO, CANADA |                        |
| CHECKED                 | APPROVED | DRAWING NO.<br><b>D3183</b>                              | REV. C<br>SHEET 4 OF 4 |
| DATE<br><b>04.02.17</b> |          | TITLE<br><b>BRACKET ASSEMBLY</b>                         | SCALE<br>1:1           |

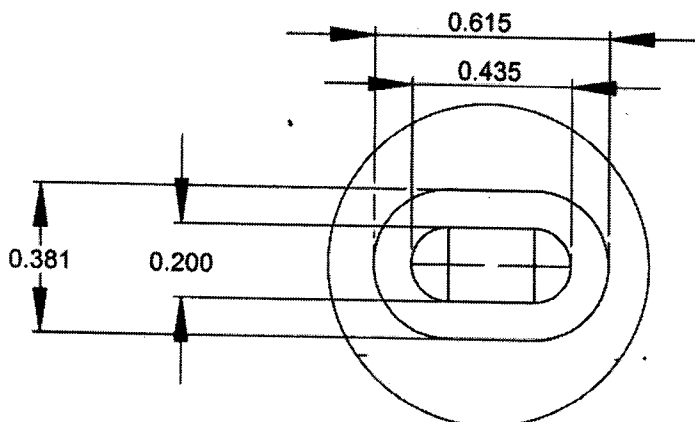


DETAIL A (2 : 1)

**RELEASED**  
04.03.01

**DEO ATTACHED**

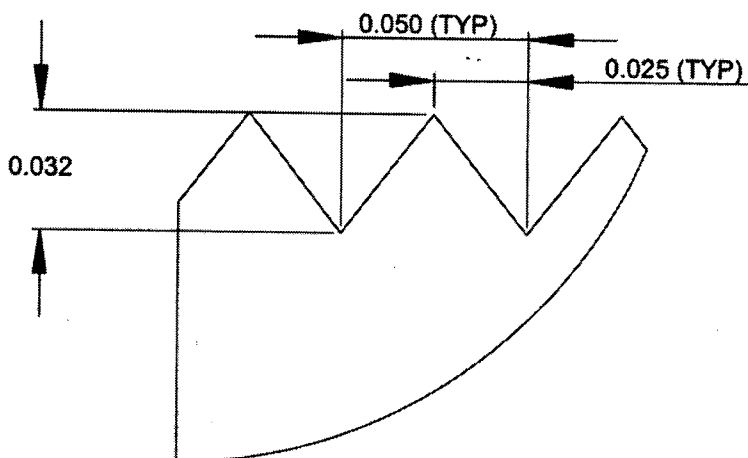

DETAIL B (20 : 1)

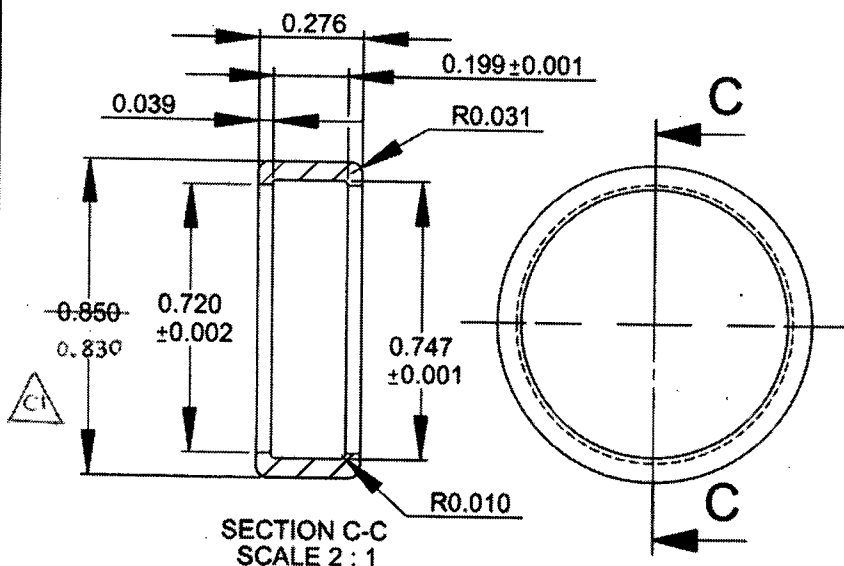

**D3183-9 CAP**

- 1) MATERIAL: DELRIN ROD, Ø1.00  
(REF DART SPEC. M-DELRIN-R1.00)
- 2) TOLERANCES ARE PER DART QSI 018  
UNLESS OTHERWISE NOTED
- 3) ALL DIMENSIONS ARE IN INCHES

**D3183-045 BEARING ASSEMBLY**

- 1) ASSEMBLE D3183-5 BEARING AND  
D3183-9 CAP

**COPYRIGHT © 2003 BY DART AEROSPACE LTD.**

THIS DOCUMENT IS PRIVATE AND CONFIDENTIAL AND IS SUPPLIED ON THE EXPRESS CONDITION THAT IT IS NOT TO BE USED FOR ANY PURPOSE OR COPIED OR COMMUNICATED TO ANY OTHER PERSON WITHOUT WRITTEN PERMISSION FROM DART AEROSPACE LTD.

